GROUND FLOOR

PLANS WITH SMOKE DETECTORS/ALARMS SHOWN

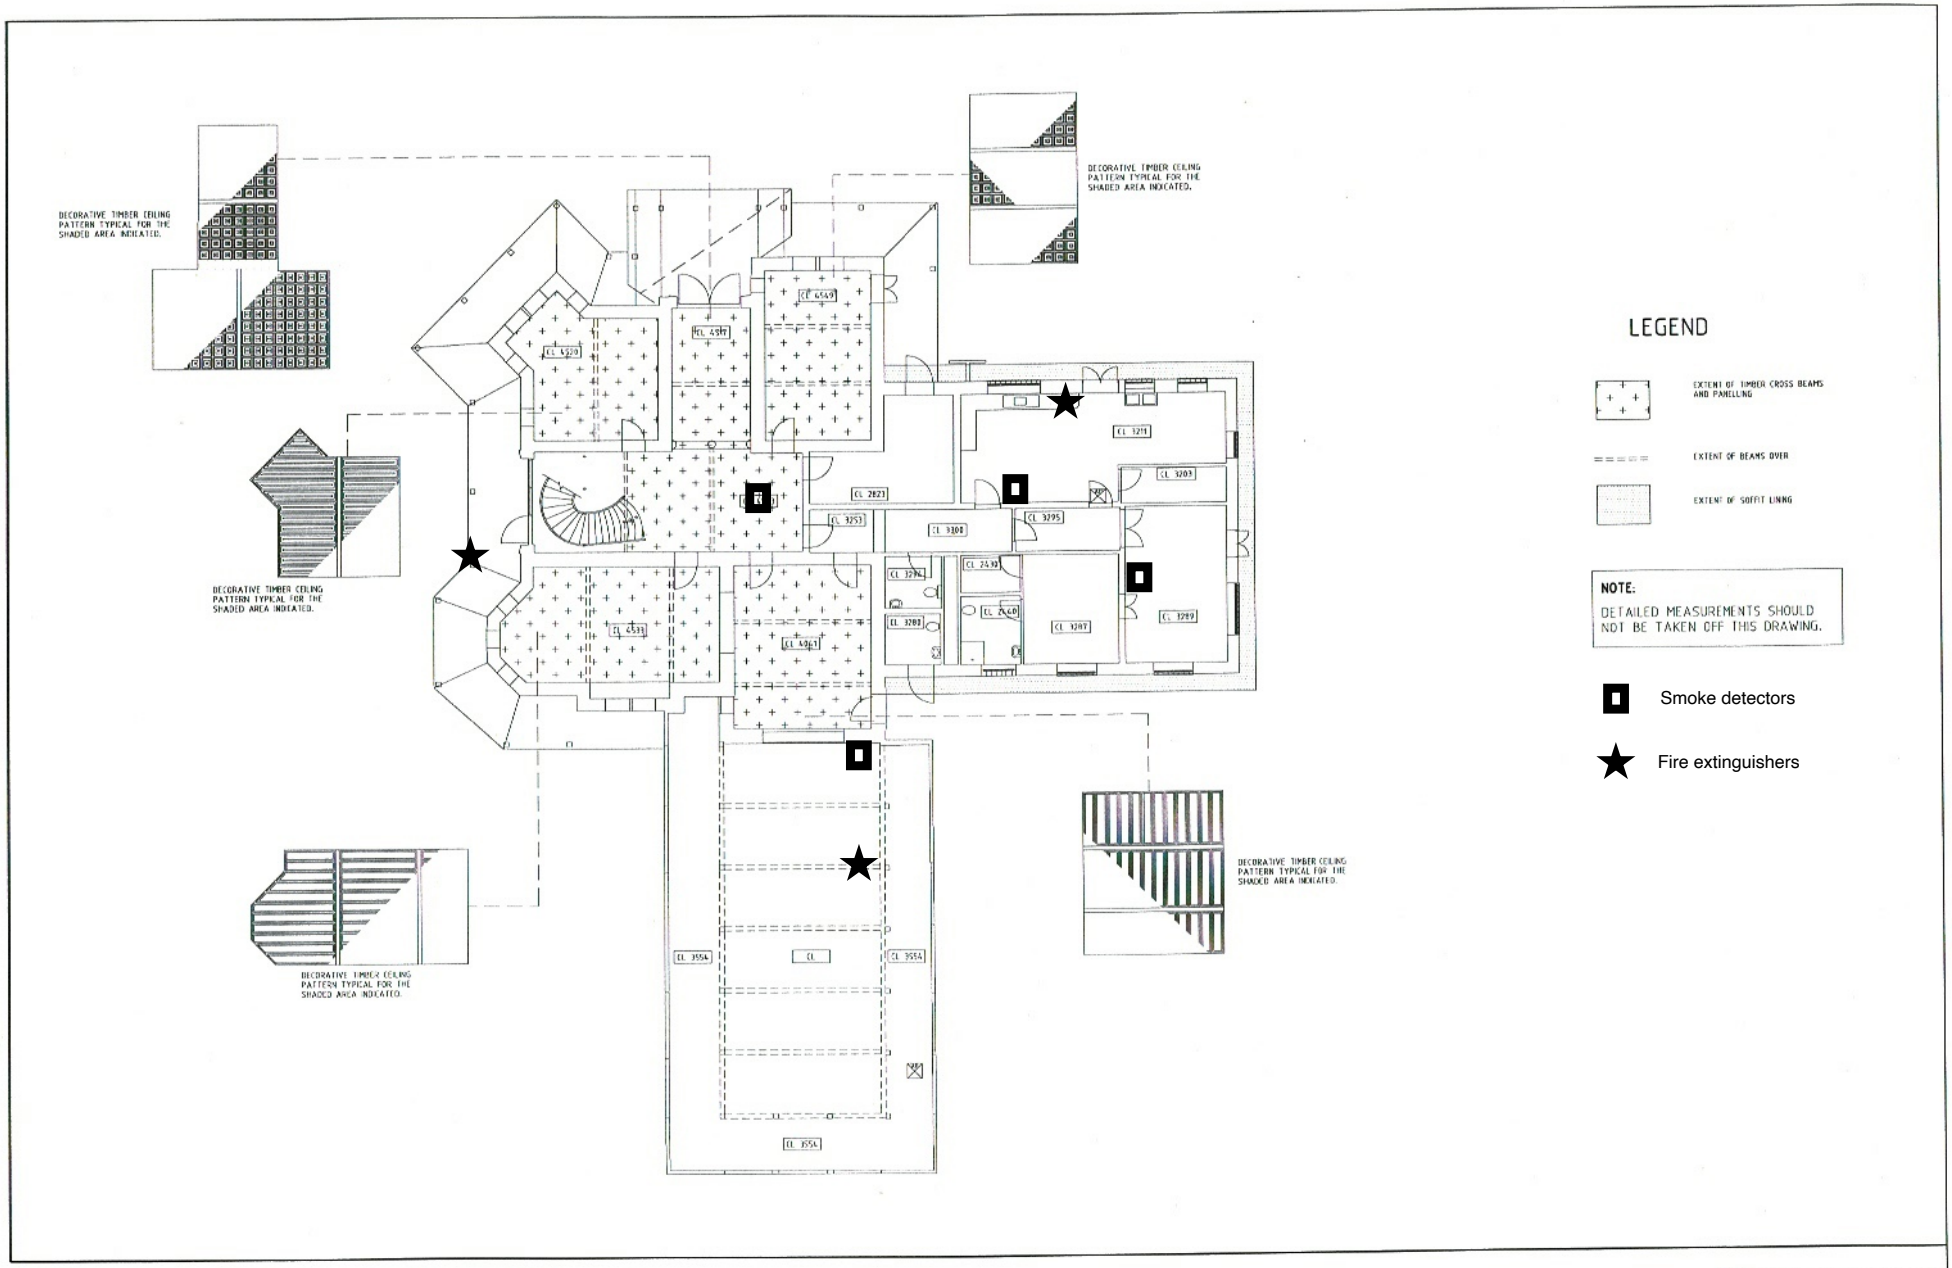

GHD ARCHITECTS

COCOS (KEELING) ISLANDS, HOME ISLAND
LOT 14 OCEANIA HOUSE 'AS CONSTRUCTED'
GROUND FLOOR CEILING PLAN

Drawing No. 8501-01AF7	
Scale: 1:200	Date: Sept 01
Designer:	Drawn: jb

N:\611\85010100\cad\01AF7.dwg

FIRST FLOOR

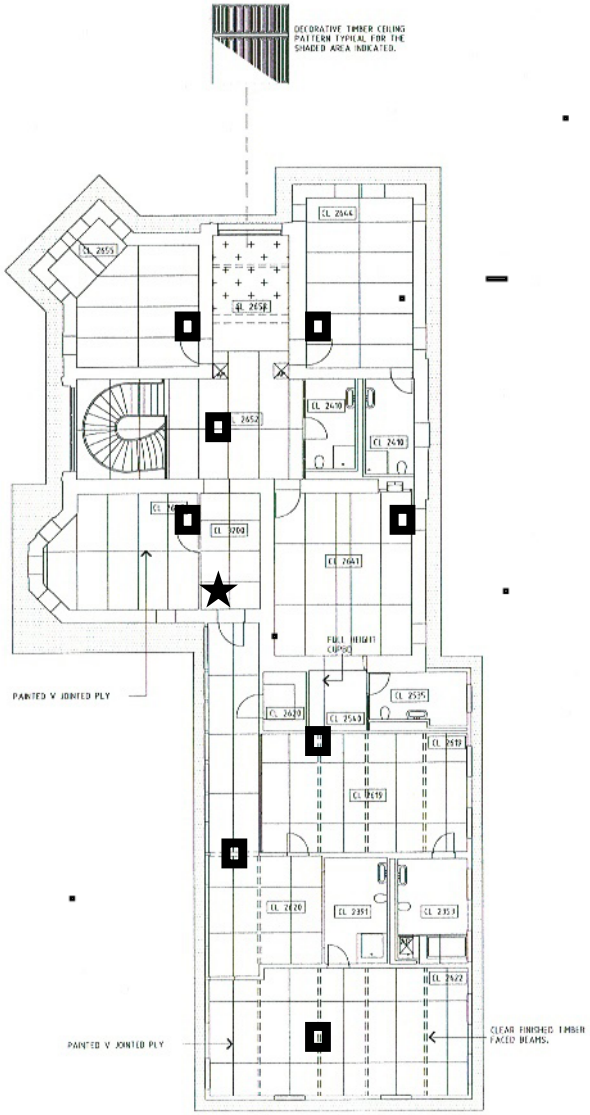

NOTE:

EXTENT OF SOFFIT LINING

LEGEND

INDICATES BEAM OVER

EXTENT OF TIMBER CROSS BEAMS AND PANELLING

EXTENT OF SOFFIT LINING

NOTE:
DETAILED MEASUREMENTS SHOULD NOT BE TAKEN OFF THIS DRAWING.

Smoke detectors

Fire extinguishers

GHD ARCHITECTS

COCOS (KEELING) ISLANDS, HOME ISLAND
LOT 14 OCEANIA HOUSE 'AS CONSTRUCTED'
FIRST FLOOR CEILING PLAN

Drawing No. 8501-01AF8	
Scale: 1:200	Date: Sept 01
Designer:	Drawn: jb

N:\611\85010100\cad\01AF8.dwg